

Beehive

The '60's Musical

For Maryland Arts Festival at the Harold Kaplan Concert Hall Theatre
Directed By Leslie Owens-Harrington





DESIGN BY GREGG HILLMAR
8406 YOLANDA ROAD
RICHMOND, VA 23229
804.683.2503
GREGG@HILLMARDESIGN.COM
[HTTP://WWW.HILLMARDESIGN.COM](http://www.hillmar.com)
SHOW PAGE AT [HTTP://WWW.HILLMARDESIGN.COM/BEEHIVE/](http://www.hillmar.com/BEEHIVE/)



ASSISTANT SCENIC & LIGHTING DESIGNER: JD JUMP
PRODUCTION MANAGER: HEATHER SORENSON
TECHNICAL DIRECTOR: TONY ROSAS

PLATE 1- FLOORPLAN
PLATE 2- SECTION
PLATE 3- PLATFORM DETAILS
PLATE 4- FLATAGE ELEVATIONS
PLATE 5- SHIMMER CURTAIN ELEVATION
PLATE 6- PAINTER'S ELEVATION, PLATFORMS
PLATE 7- PAINTER'S ELEVATION, FLATS

Note:
THIS DOCUMENT DETAILS PLAYING POSITIONS, SHAPES AND COLOUR RELATED TO THE VISUAL ASPECTS OF THE PRODUCTION ONLY. IT IS UNDERSTOOD THAT ALL SPECIFICATIONS RELATE SOLELY TO THE APPEARANCE OF THE DESIGN, AND IN NO WAY DOES THE DESIGNER ASSUME RESPONSIBILITY FOR THE SAFETY, STRUCTURAL INTEGRITY, BUILDING, RIGGING, CONSTRUCTION, FABRICATION, MATERIAL OR EQUIPMENT USED IN THE EXECUTION OF THE DESIGN.

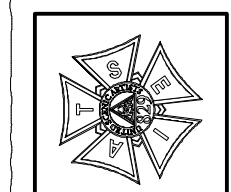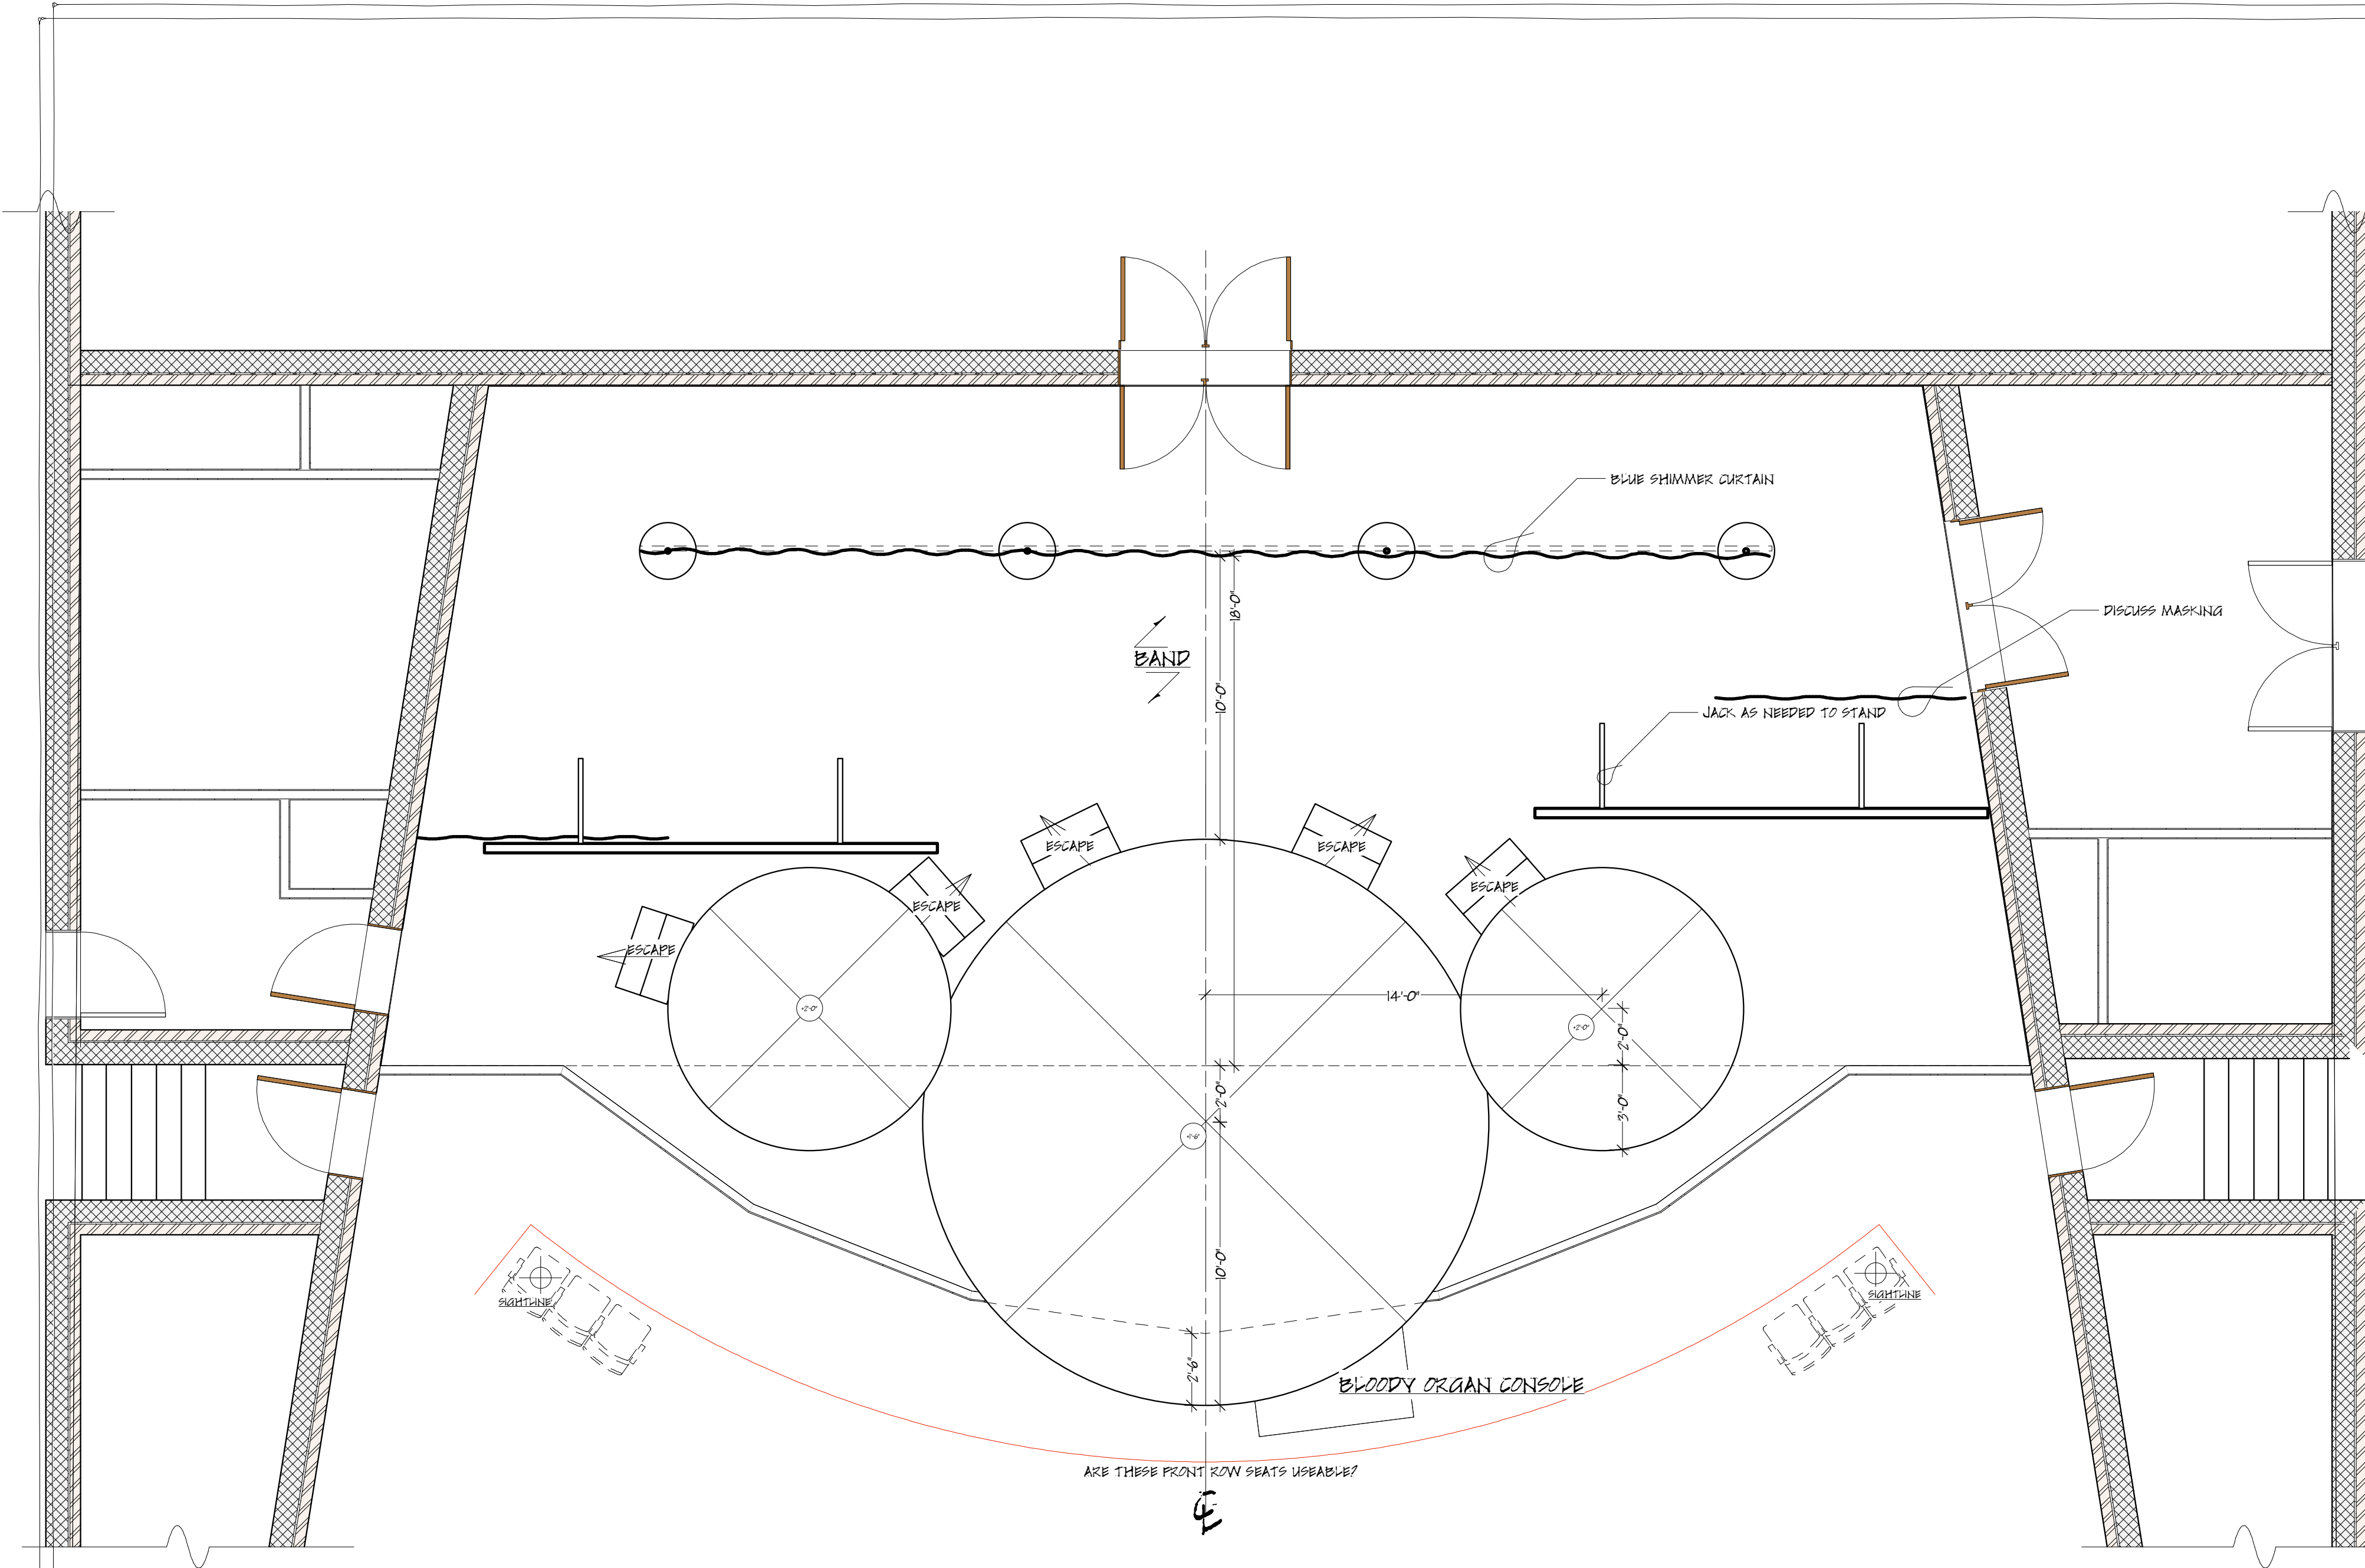

design by gregg hullmar

804.683.2503, gregg@hullmar-design.com
www.hullmar-design.com
© gregg hullmar 2004

Beehive

Directed By Leslie Owens-Harrington

For Maryland Arts Festival

At Harold Kaplan Concert Hall


ID: Tony Roper

FloorPlan- REVISED

Scale: 0'-1/4"=1'-0" draft: gah 4/28/06

Revised: 05/22/06

Plate# 1 of 7

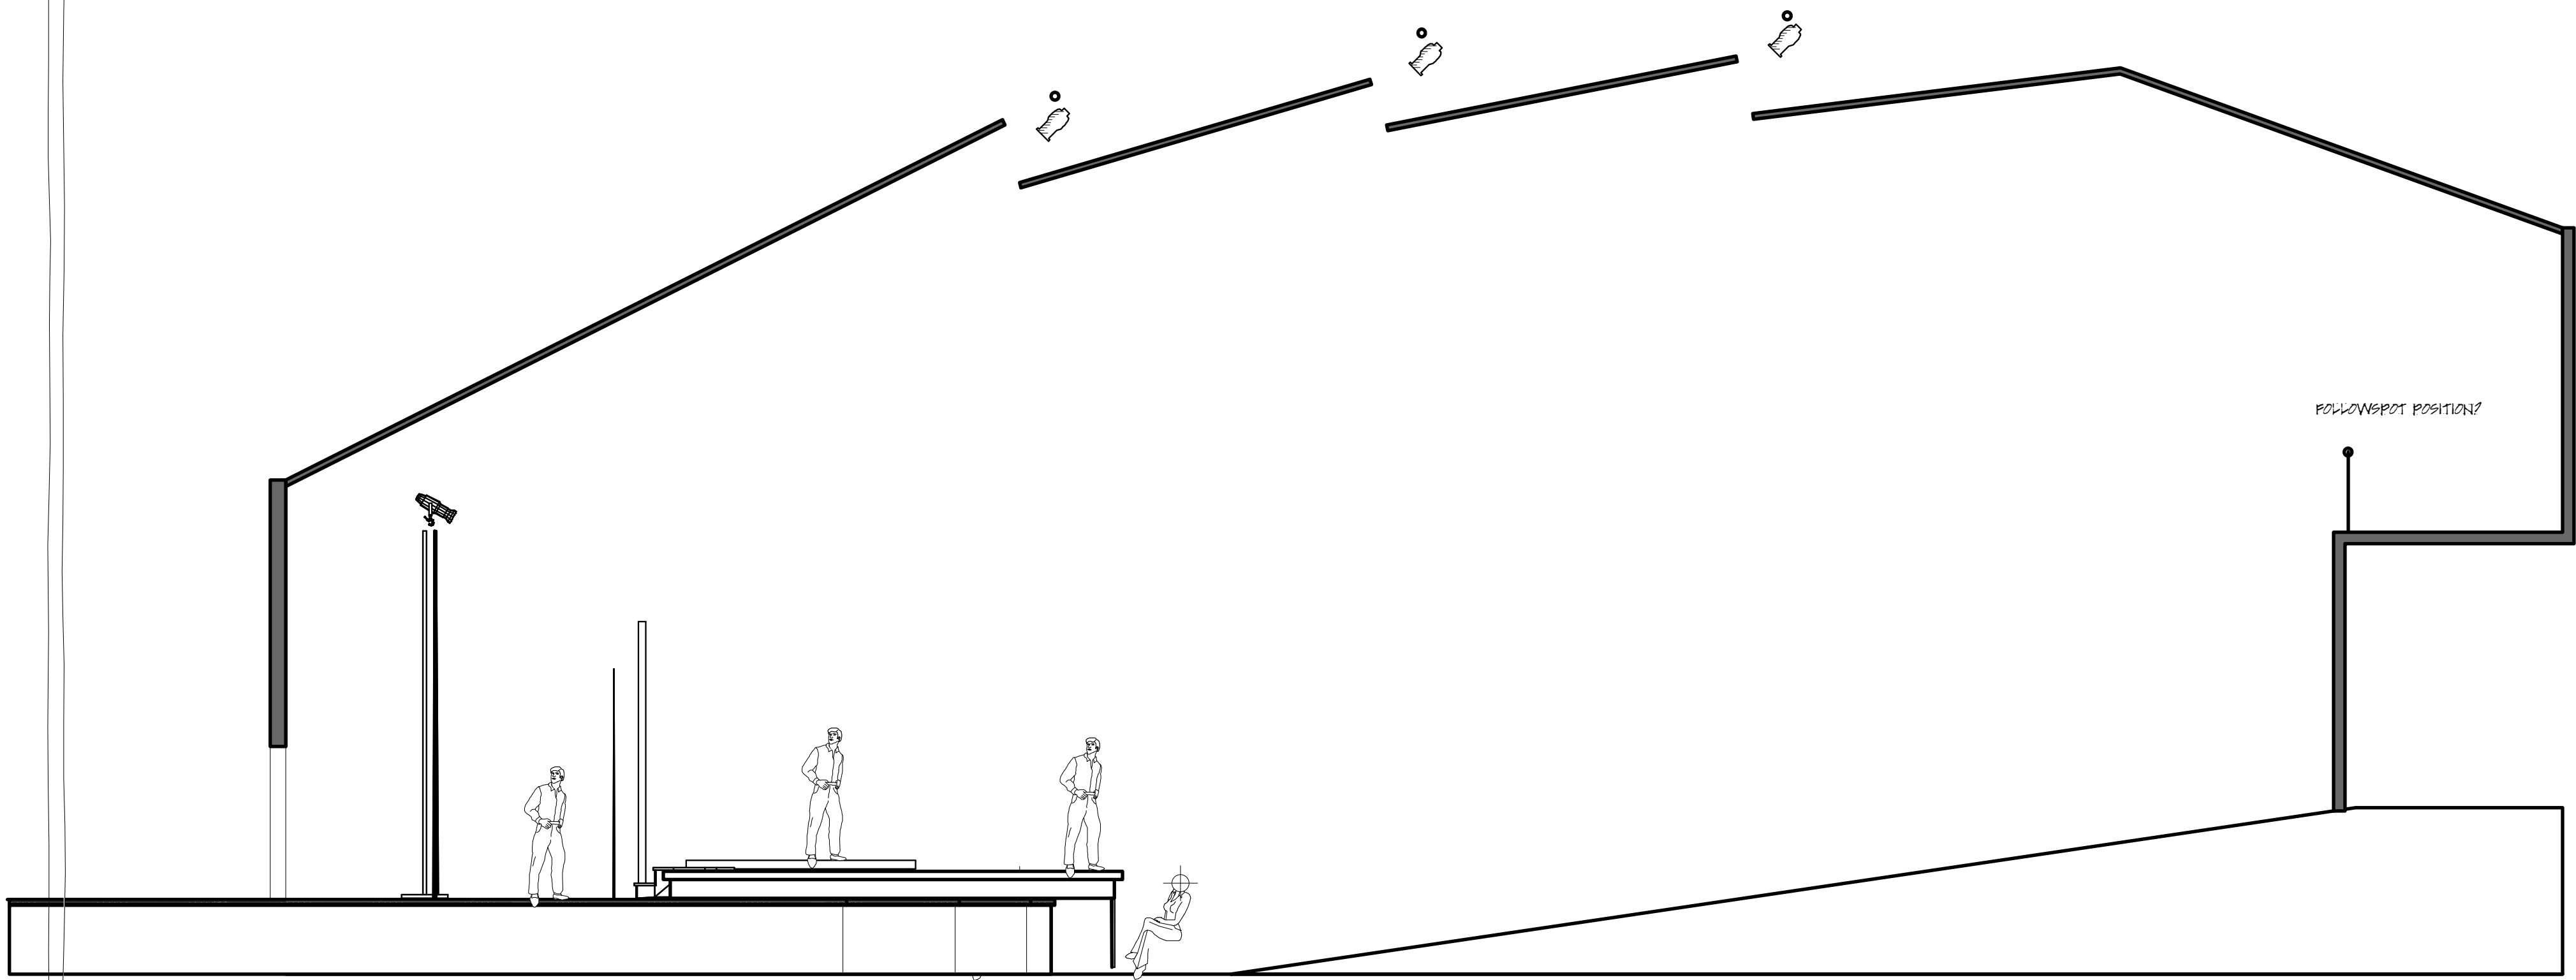

Plate# 2

of 7

Center Line Section- REVISED

Scale: 0'-1/4"=1'-0" draft: gah 5/13/06

Revised: 05/22/06

Beehive

Directed By Leslie Owens-Harrington

For Maryland Arts Festival

At: Harold Kaplan Concert Hall

design by gregg hillmar

Asst. Design: JD Jump

PM: Heather Sorrenson



ID: Tony Rivas

804.683.2503 j.gregg@hillmar-design.com

www.hillmar-design.com

© gregg hillmar 2006



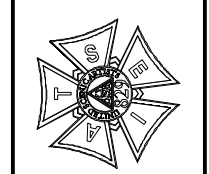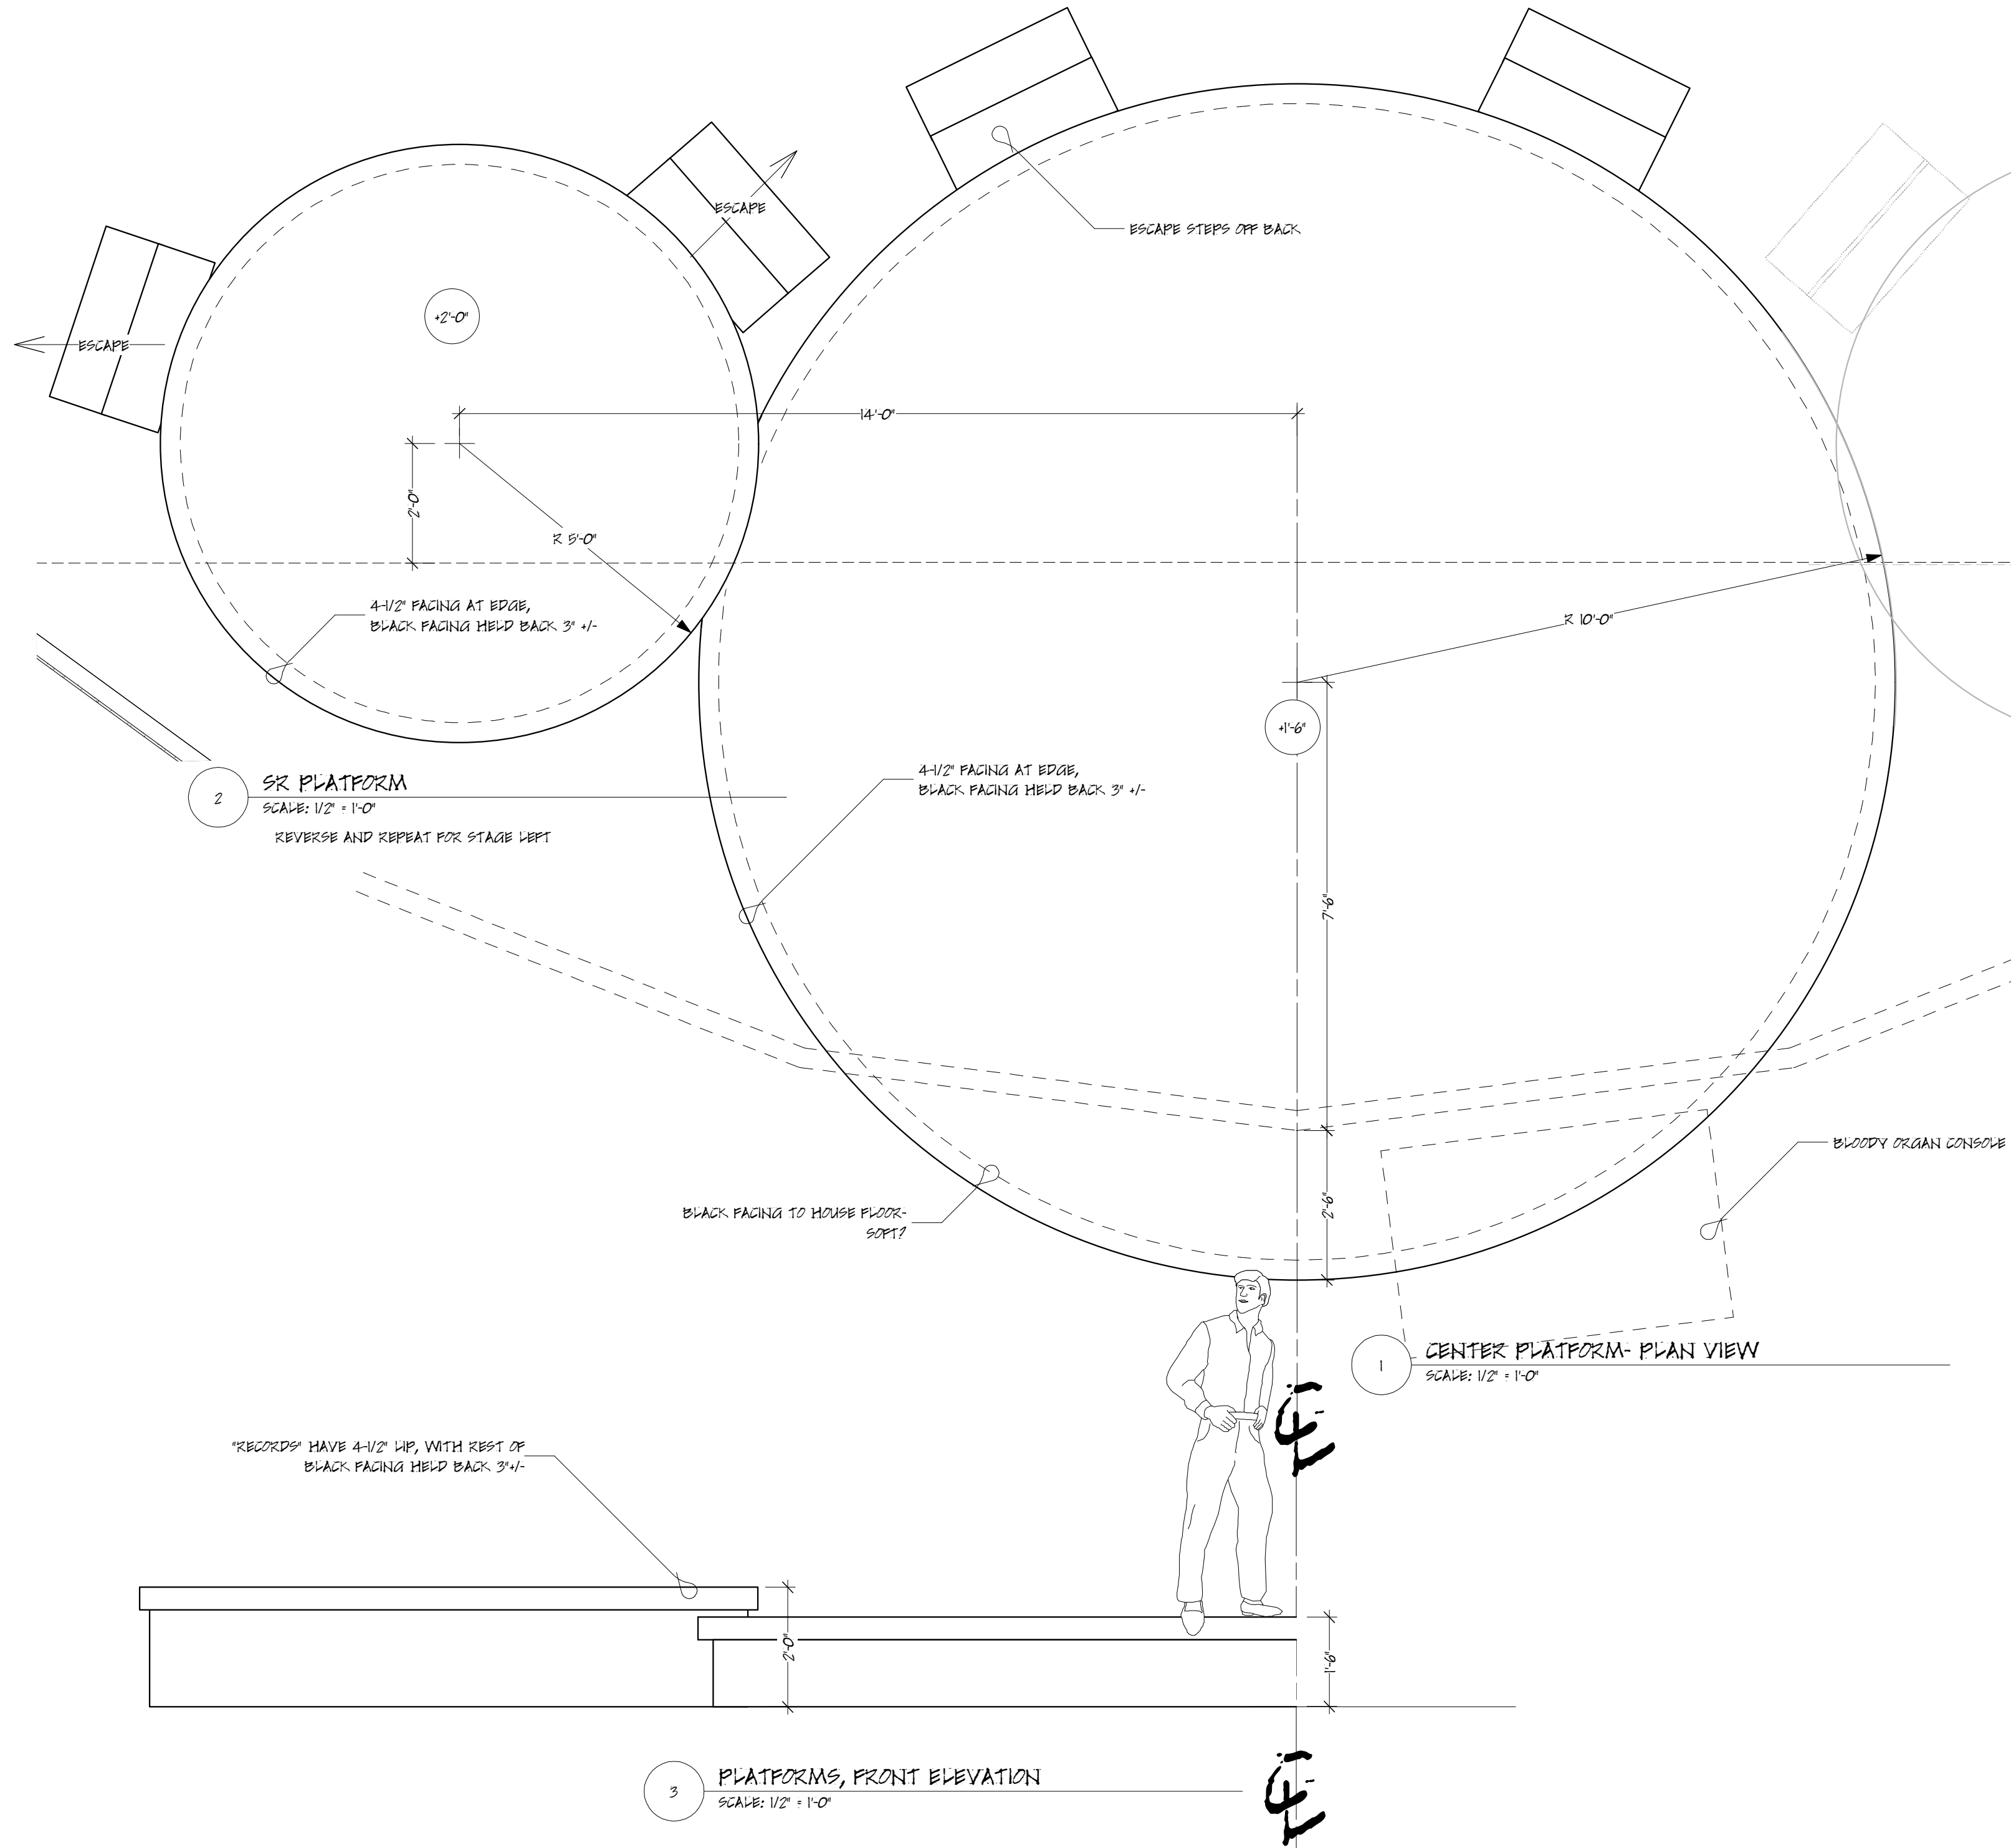

design by gregg hillmar

Assoc. Designer: JD Jump
PMT Heather Sorrenson
www.hillmar-design.com
© gregg hillmar 2006

Beehive

Directed By Leslie Owens-Harrington

For Maryland Arts Festival

At Harold Kaplan Concert Hall


Platform Details- REVISED

Scale: 0'-1/2" = 1'-0" draft: gah 5/14/06

Revised: 05/22/06


Plate# 3

0 of 7

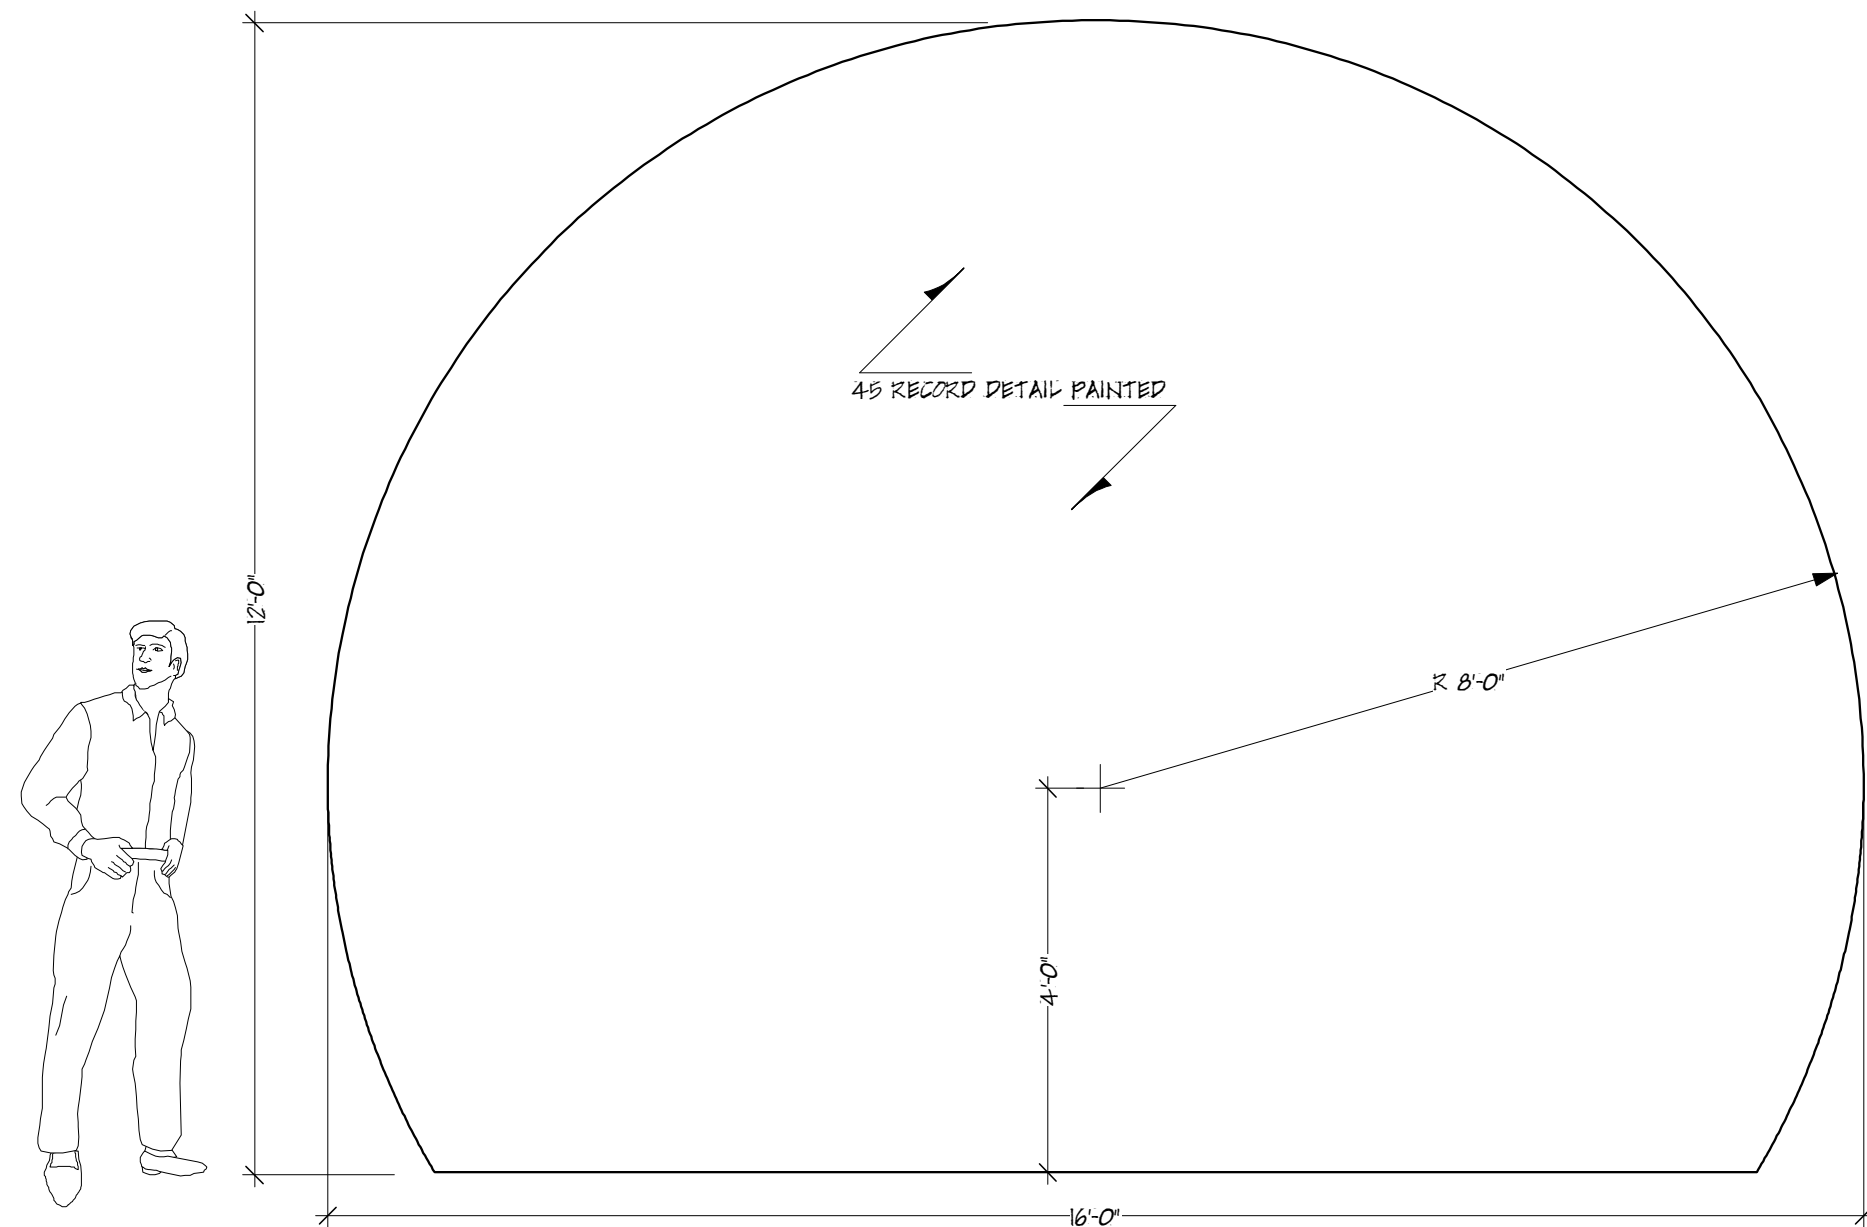


1 SL UPRIGHT RECORD FRONT ELEVATION
SCALE: 1/2" = 1'-0"

REPEAT FOR STAGE RIGHT

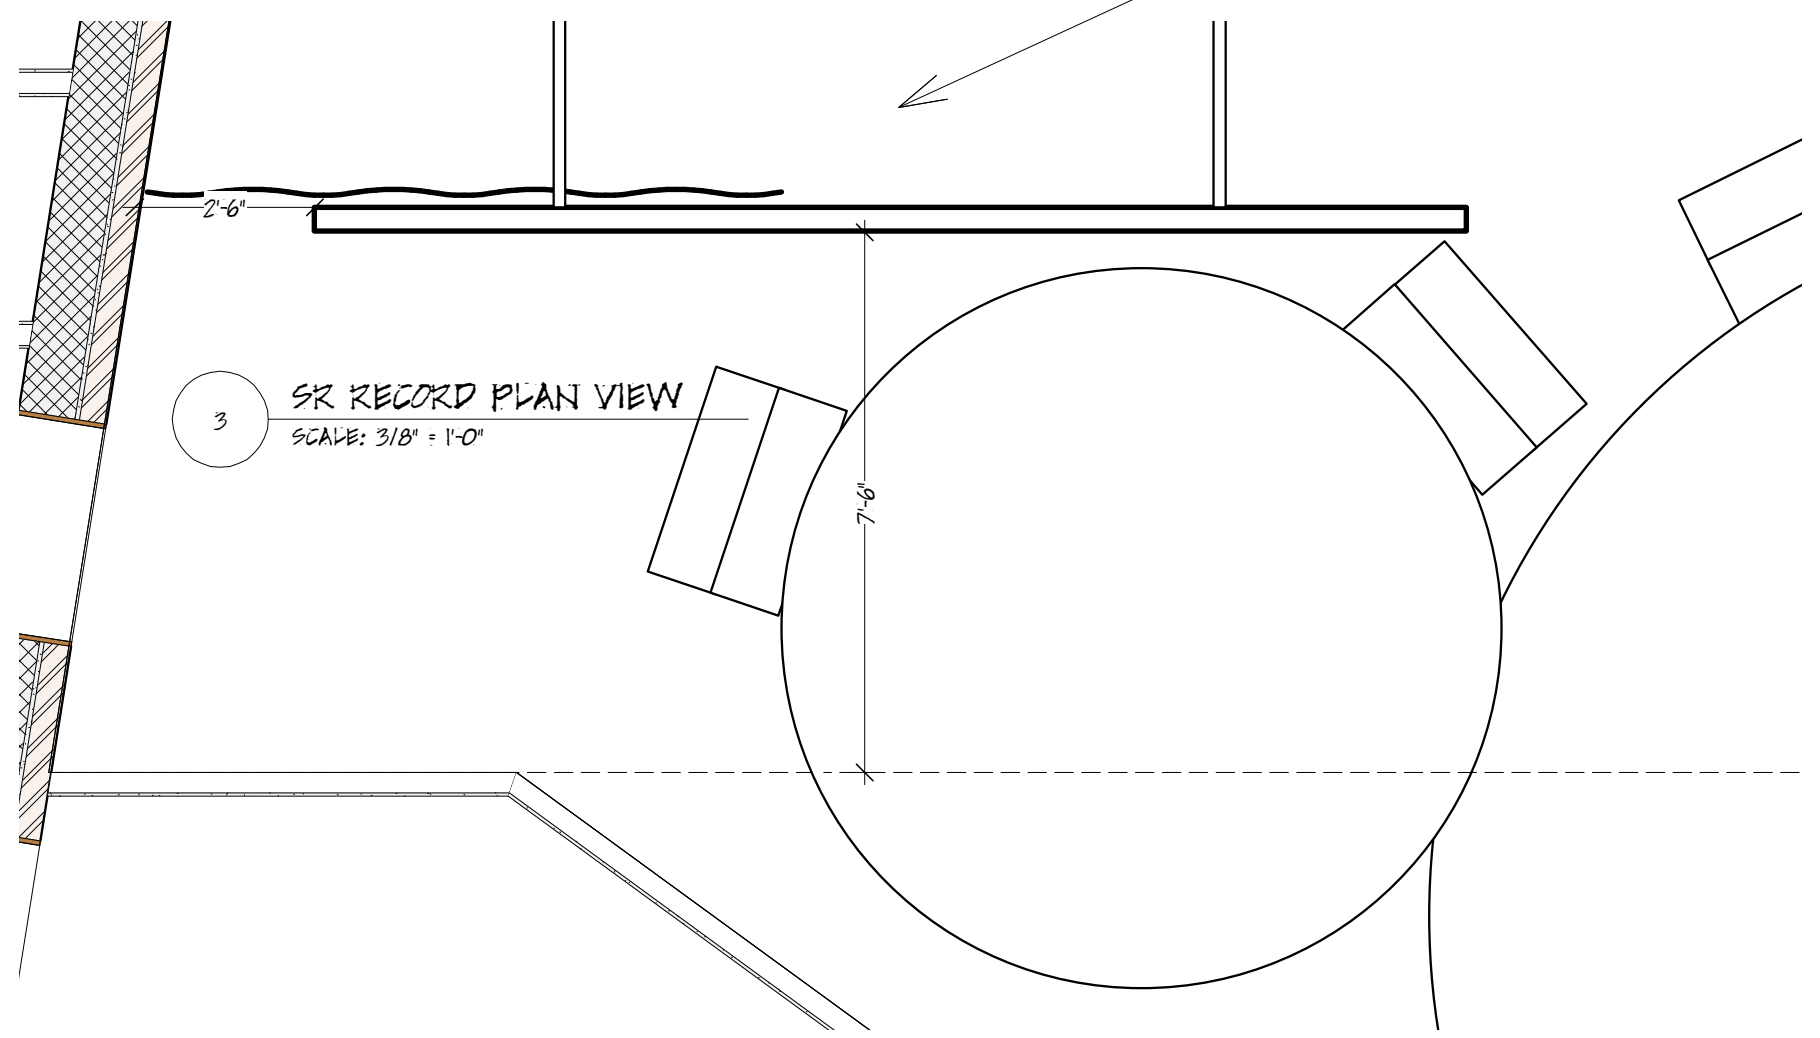

3 SR RECORD PLAN VIEW
SCALE: 3/8" = 1'-0"

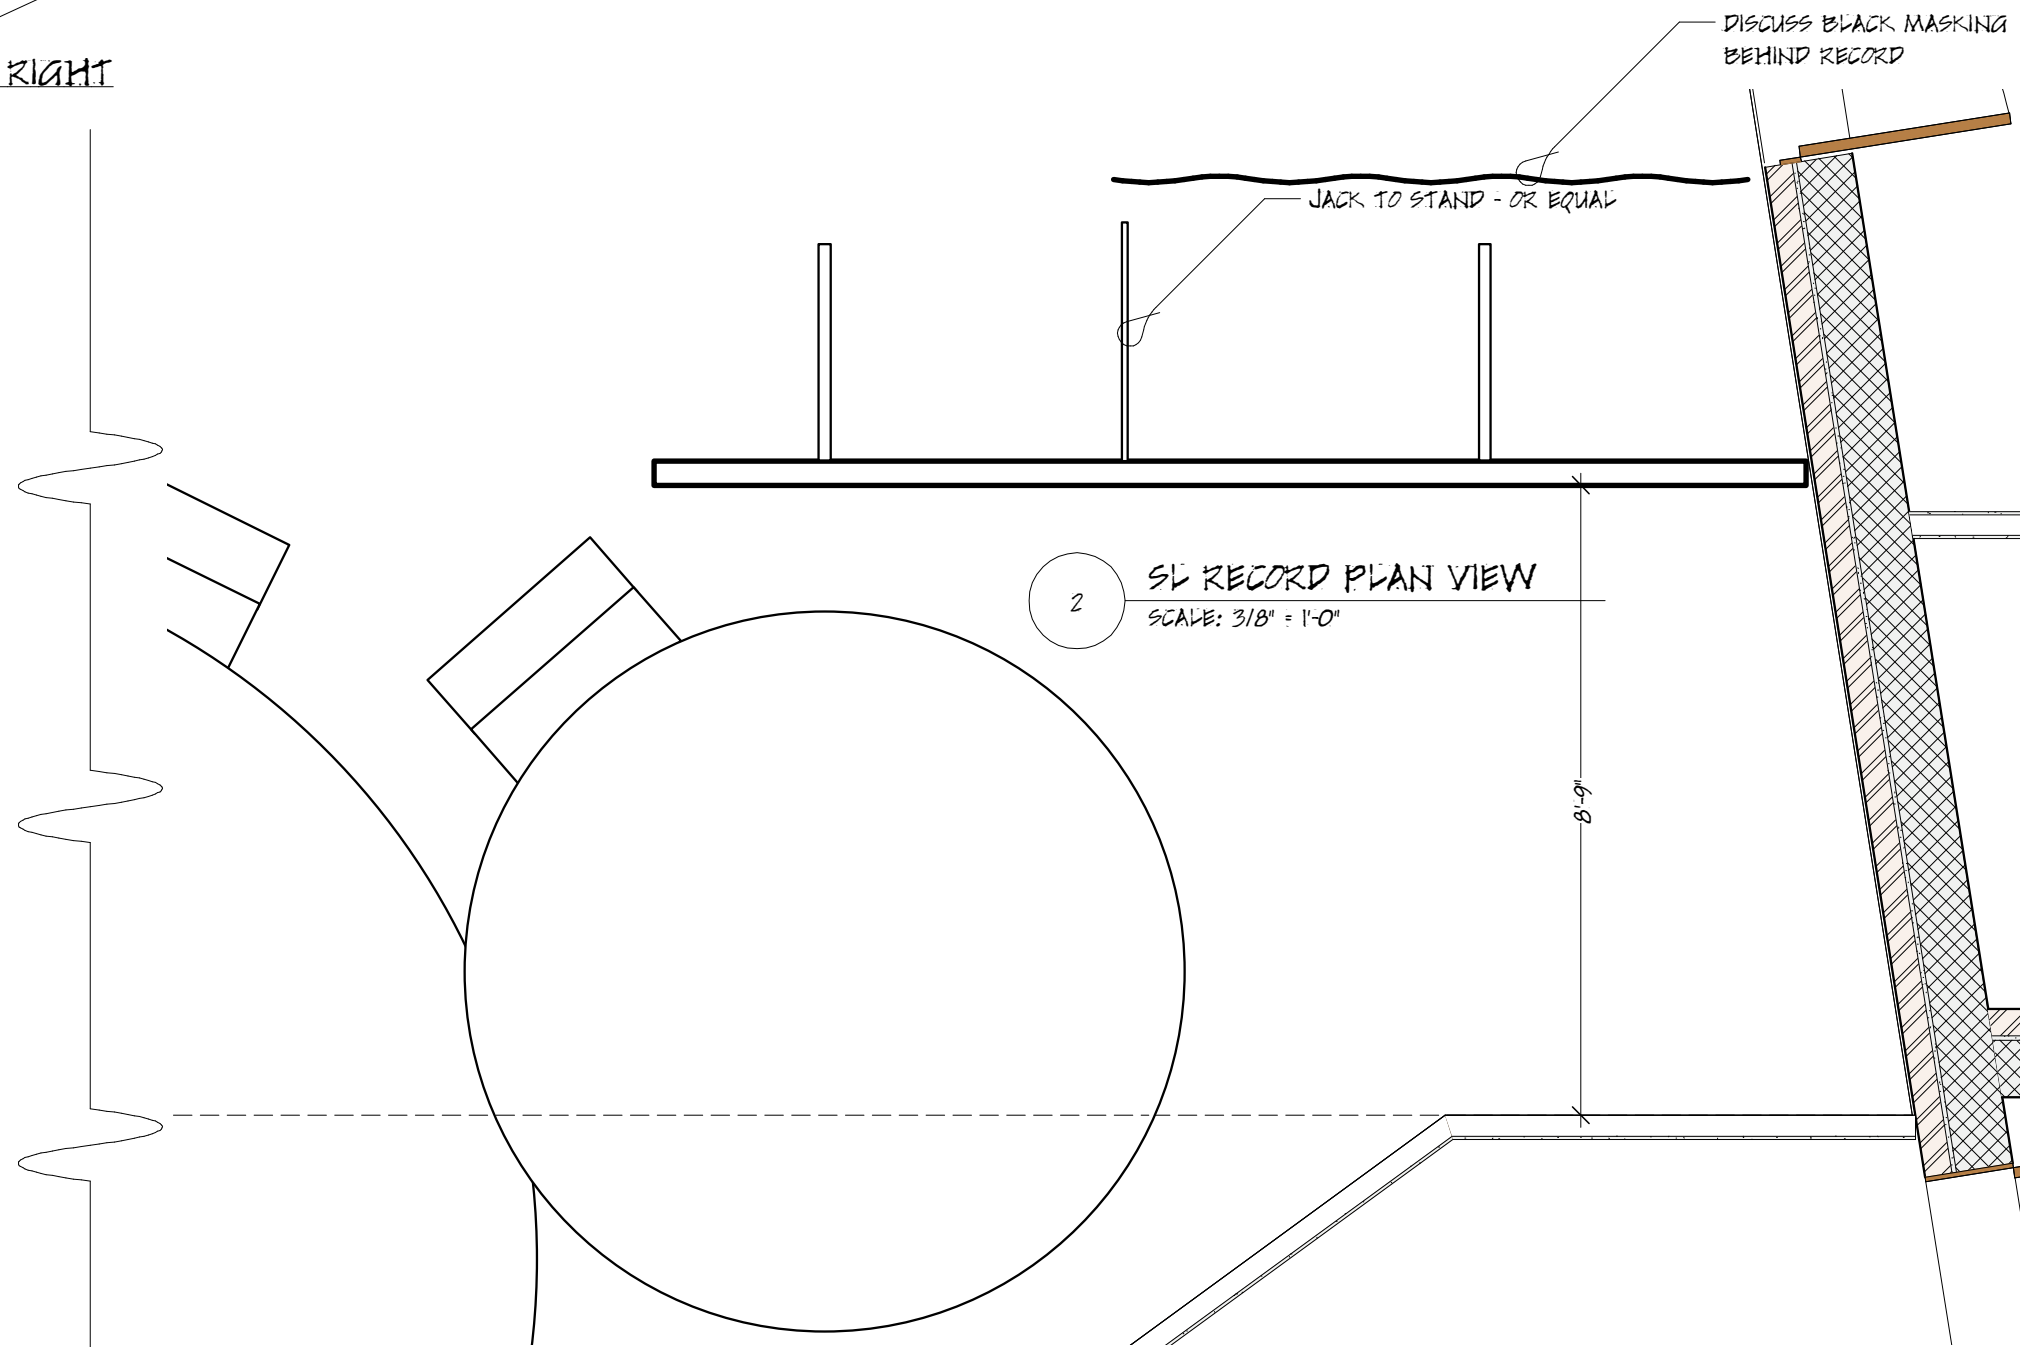

2 SL RECORD PLAN VIEW
SCALE: 3/8" = 1'-0"



design by gregg hullmar

Assoc. Designer: JD Jump
PMT Heather Sorrenson
www.hullmar-design.com
© gregg hullmar 2006

Beehive

Directed By Leslie Owens-Harrington

At Harold Kaplan Concert Hall

For Maryland Arts Festival

Flat Elevations- REVISED


Scale: 0'-1/2" = 1'-0"

draft: gah

Revised: 05/22/06


Plate# 4

of 7

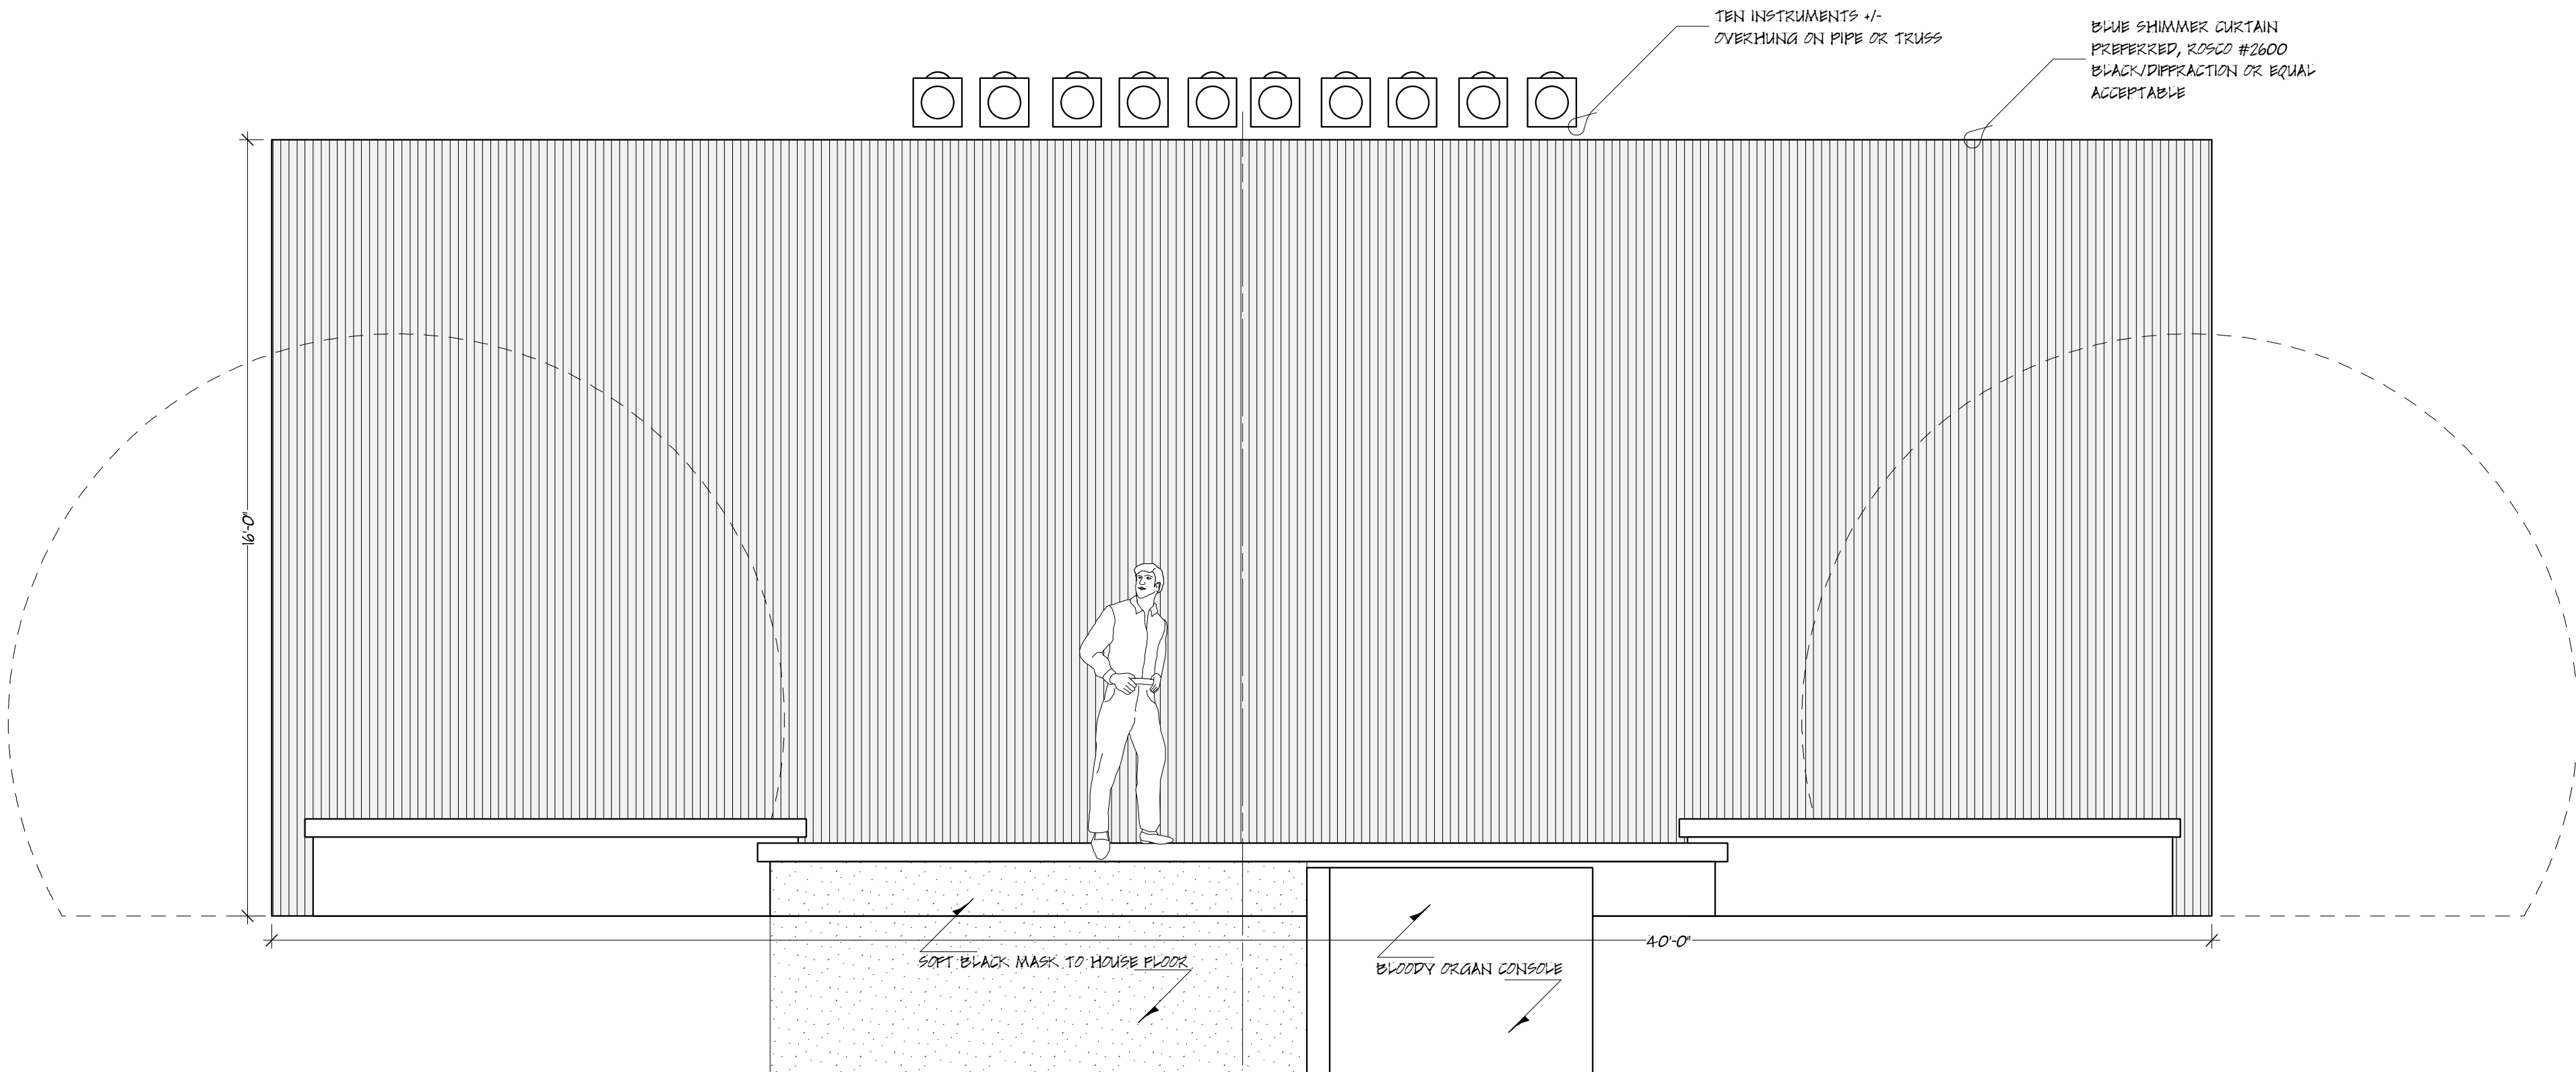

1 DRAPE FRONT ELEVATION-WITH REST OF SET...
SCALE: 3/8" = 1'-0"

TFI

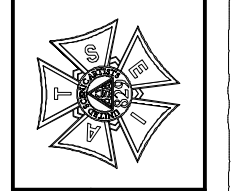

design by gregg hillmar
804.683.2503 gregg@hillmar.com
www.hillmar.com
© gregg hillmar 2006

Beehive
Directed By Leslie Owens-Harrington
At Harold Kaplan Concert Hall
For Maryland Arts Festival

Plate#	5	Front Elevation- REVISED	
Scale: 0' 3/8"=1'-0"	draft: gah	5/10/06	
Revised: 05/22/06			